


MARK YOUR PROPERTY OUTLINE ON ARCHITECT'S PLAN

Before scanning the architect's plan to upload for a floor plan order, mark the outline of your property clearly so that we know the area to be drawn.

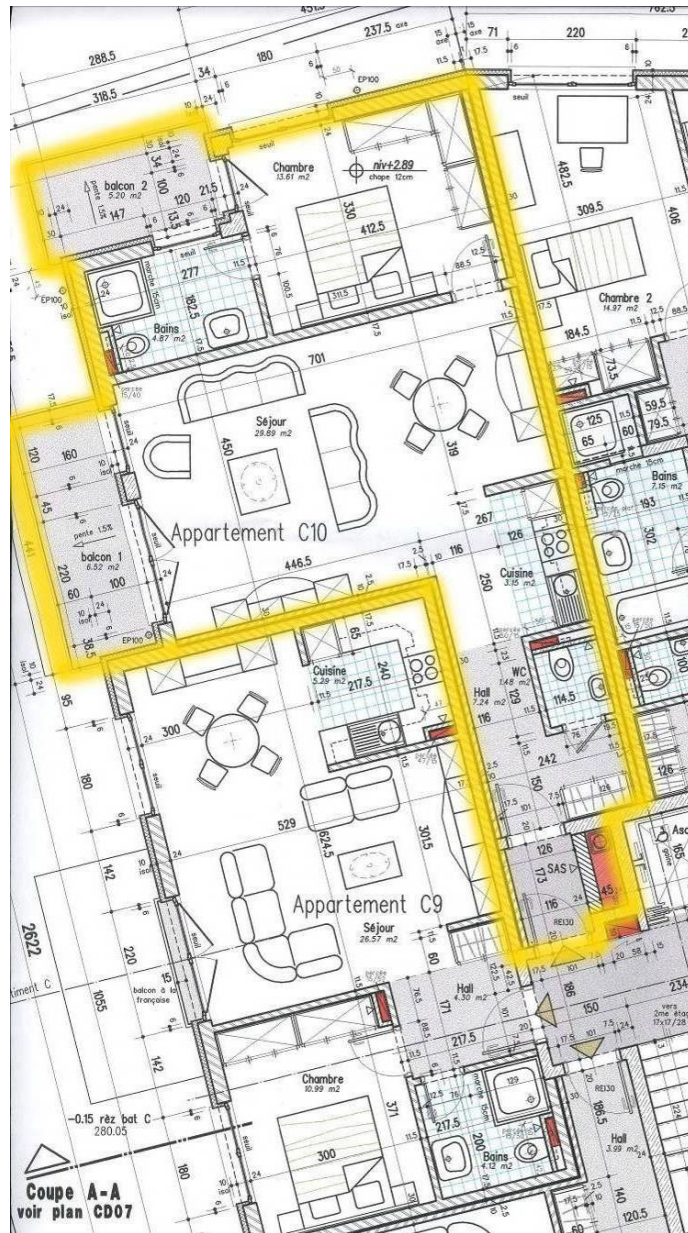

GUIDELINES TO MARK AMENDMENTS ON THE ARCHITECT'S PLAN

If you have an old architectural plan, clearly mark and update any changes and renovations, to ensure that the most up-to-date plan version is uploaded.

PREFERABLE COLOR CODING FOR MARK-UPS

- Mark entities with **Red color** which you want to remove.
- Use **Green color** for addition of entities.
- Use **Blue color** for any notes or dimension measured in any room.

ILLUSTRATION BELOW

